Attachment 13

Baghouse Wall Depictions

Attachment 13 - Baghouse Wall Depictions

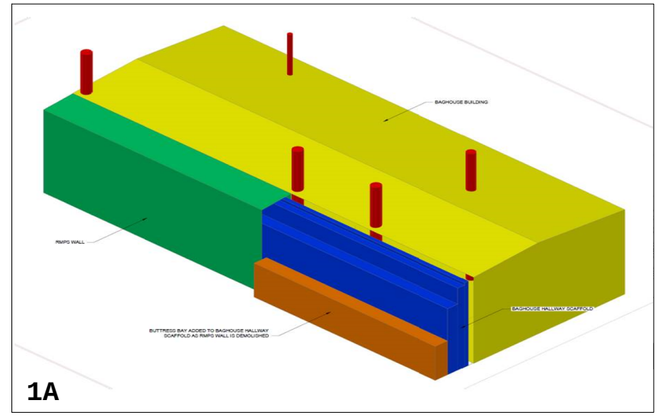

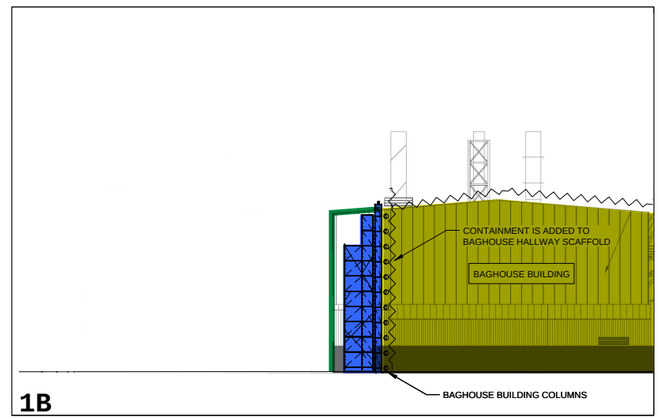

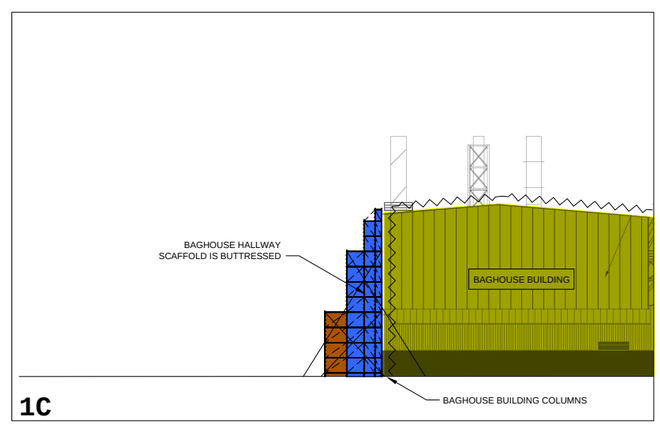

NOTE: NOT ALL BRACING SHOWN FOR CLARITY

ORIGINAL P.E. SIGNATURE IN BLUE INK

THE DRAWINGS THE PROPERTY OF SAFWAY SERVICES, LLC AND MAY NOT BE COPIED OR REPRODUCED IN WHOLE OR IN PART WITHOUT WRITTEN PERMISSION OF SAFWAY SERVICES, LLC

Rev.	Description	Date:	By:	Chkd:
◁	------AS-BUILT------	-	-	-
◁	X FOR CONSTRUCTION	-	-	-
◁	------FOR APPROVAL	-	-	-
◁	------FOR QUOTATION	-	-	-
◁	------PRELIMINARY---	-	-	-
◁	------CONCEPT DRAWING	-	-	-
◁	------NOT FOR CONST.	-	-	-

SAFWAY.
Safway Services, LLC
www.safway.com
© 2009 Safway Services, LLC

Branch: LOS ANGELES [072]
Eng' Loc: ISG
Project: EXIDE HAKI
HAKI ROOF ENCLOSURE
Description: SEGMENT 1 TO SEGMENT 3 SCAFFOLD TRANSITION
Contractor:

Drawn by: SMT	05/02/2017	
Checked: PAJ	05/02/2017	
Project Number: 152097	Dwg. No. AD-3	Rev. Ltr. -

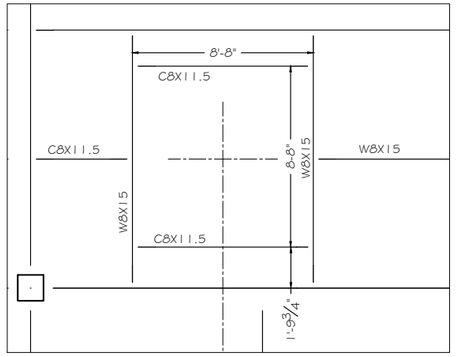

2 EXHUST OPENING
Scale: 1/4"=1'

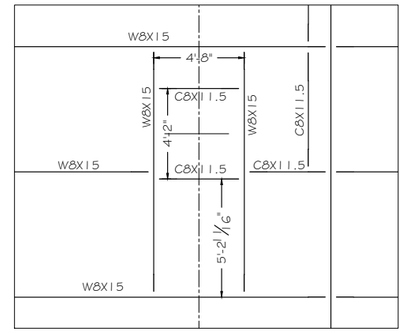

3 EXHUST OPENING
Scale: 1/4"=1'

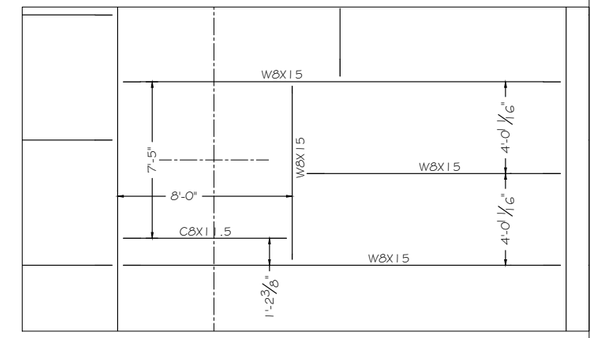

4 EXHUST OPENING
Scale: 1/4"=1'

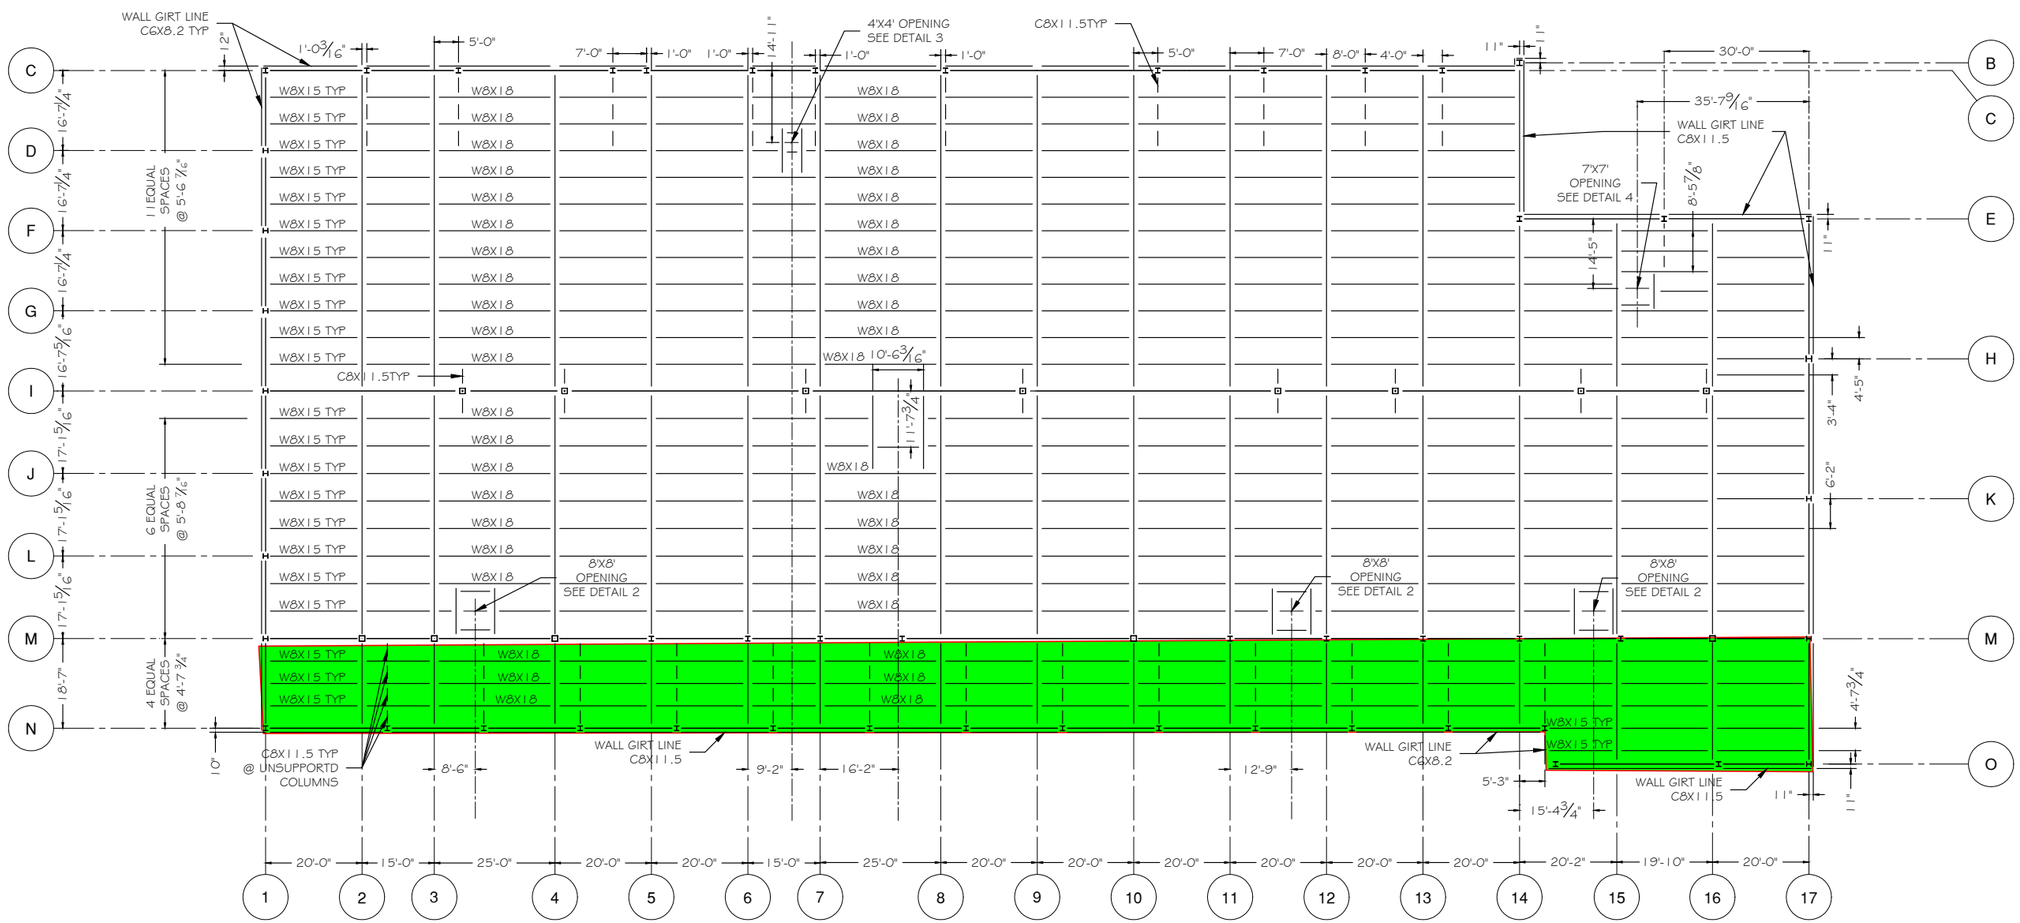

1 PURLIN ROOF PLAN
Scale: 1:225

NOTE: PURLINS TO BE W8X15 FOR SPANS UP TO 24'
PURLINS TO BE W8X18 FOR SPANS OVER 24'

NOTE: GIRTS TO BE C6X8.2 FOR SPANS UP TO 24', @ 8' O.C.MAX
GIRTS TO BE C8X11.5 FOR SPANS 24' TO 32", @ 8' O.C.MAX
GIRTS TO BE C8X18.75 FOR SPANS MORE THAN 32', @ 8' O.C.MA

MK.	DATE	REVISION	BY	CHK'D.	DATE

PERMIT APPLICATIONS INFORMATION

PERMITS REQUIRED	SUBMITTED BY	DATE	PERMITS RECEIVED	DATE	COMMENTS	DETAILS
AIR						
WATER						
BLDG.						

DRAWING RECORD INFORMATION

DWN. BY: Randy Brown II	DATE: 01-15-11	SCALE: 1:225	
CHK. BY:	DATE:	APPRD. BY:	
APPR. BY:	DATE:	STATUS:	

Advanced Constructors Corp. Huntington Beach, Ca

STEEL ROOF PLAN-PURLINS:

PROJECT NUMBER	FAC. NO.	DEPT/AREA	DRAWING TYPE	DRAWING NUMBER	REV NO.
241-1	---	---	----	S.6.0	0

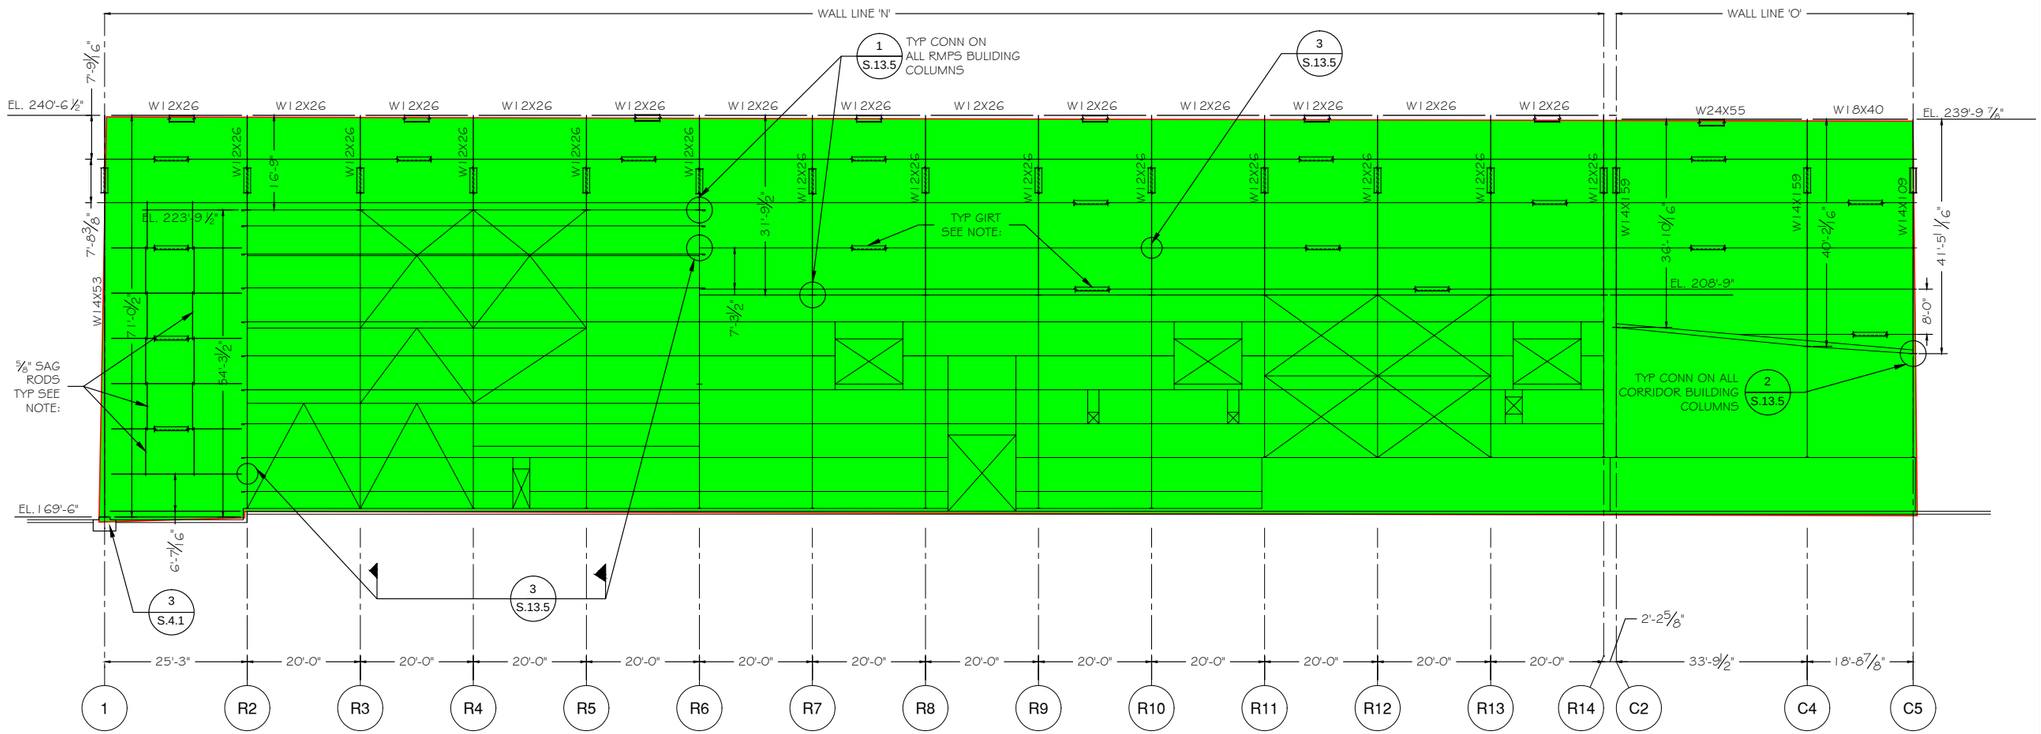

1 WEST STEEL ELEVATION @ WALL LINE 'N'

Scale: 1/16"=1'

NOTE: SEE BRACE DETAILS ON S.13.4
NOTE: ELEVATIONS ARE TO T.O. BEAM AND B.O. BASE PLATES
NOTE: GIRTS TO BE C6X8.2 FOR SPANS UP TO 24', @ 8' O.C.MAX
GIRTS TO BE C8X11.5 FOR SPANS 24' TO 32", @ 8' O.C.MAX
GIRTS TO BE C8X18.75 FOR SPANS MORE THAN 32', @ 8' O.C.MAX
NOTE: 5/8" SAG RODS ON ALL GIRTS @ 8' MAX O.C.

ADVANCED CONSTRUCTORS CORP.

MK.	DATE	REVISION	BY	CHK'D.	DATE

PERMIT APPLICATIONS INFORMATION

PERMITS REQUIRED	SUBMITTED BY	DATE	PERMITS RECEIVED	DATE	CO NUMBER	INITIALS
AIR						
WATER						
BLDG.						

DRAWING RECORD INFORMATION

DWN. BY: Randy Brown II DATE: 01-15-11
CHK. BY: DATE:
APPR. BY: DATE:
SCALE: 1/16"=1'
APPVD. BY:
STATUS:

Advanced Constructors Corp. Huntington Beach, Ca

WEST STEEL ELEV VIEW:

PROJECT NUMBER	FAC. NO.	DEPT/AREA	DRAWING TYPE	DRAWING NUMBER	REV NO.
241-1	---	---	----	S.10.0	0